

STATE ENGINEER  
Salem, Oregon

*Well*  
**MARI.....**

# Well Record

GR- 1574

STATE WELL NO. 10/2W-18F  
COUNTY Marion  
APPLICATION NO. GR- 1616

OWNER: Mervin N. McGill


MAILING ADDRESS: Rt. 1

LOCATION OF WELL: Owner's No. #2

CITY AND STATE: Jefferson, Oregon

SE 1/4 NW 1/4 Sec. 18 T. 10 N. S. R. 2 W., W.M.

Bearing and distance from section or subdivision  
corner 1370' E. & 2190' S. from NW cor. Sec. 18.

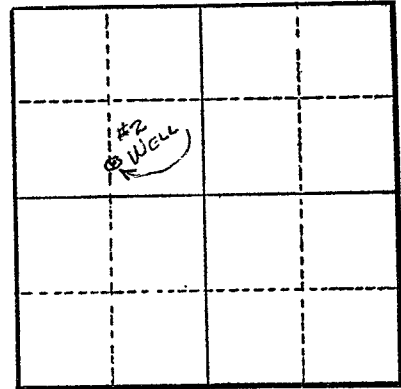

Section 18

Altitude at well 250'

TYPE OF WELL: Driven Date Constructed 1944

Depth drilled 25' Depth cased 25'

### CASING RECORD:

4"

### FINISH:

Perforated with torch slots from 18 to 25 ft.

### AQUIFERS:

### WATER LEVEL:

6 - 10 ft. (Spring to Summer)

PUMPING EQUIPMENT: Type F. M. 3" Cent. H.P. 15

Capacity 400 G.P.M.

### WELL TESTS:

Drawdown \_\_\_\_\_ ft. after \_\_\_\_\_ hours \_\_\_\_\_ G.P.M.

Drawdown \_\_\_\_\_ ft. after \_\_\_\_\_ hours \_\_\_\_\_ G.P.M.

USE OF WATER Irrigation Temp. \_\_\_\_\_ °F. \_\_\_\_\_, 19\_\_\_\_

SOURCE OF INFORMATION GR Record

DRILLER or DIGGER Owner

### ADDITIONAL DATA:

Log \_\_\_\_\_ Water Level Measurements \_\_\_\_\_ Chemical Analysis \_\_\_\_\_ Aquifer Test \_\_\_\_\_

### REMARKS:

Log: Top soil 0 to 4 ft.  
Gravel & sand 4 to 25 ft.

Irrigation of 35 acres.