

STATE ENGINEER
Salem, Oregon

MAR 16 1953

Well Record

GR- 968

STATE WELL NO. 10/2W-18L(1)
COUNTY Marion
APPLICATION NO. GR- 1002

OWNER: Charles C. Hart Jr.


MAILING ADDRESS: Rt. 1, Box 222

LOCATION OF WELL: Owner's No. #3

CITY AND STATE: Jefferson, Oregon

NE 1/4 SW 1/4 Sec. 18 T. 10 S. R. 2 W., W.M.

Bearing and distance from section or subdivision corner 2500' N. & 2800' W. from SE cor. Sec. 18.

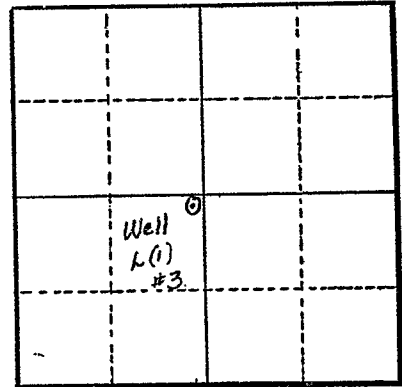

Section 18

Altitude at well 244 ft.

TYPE OF WELL: Drilled Date Constructed 1952

Depth drilled 26 ft. Depth cased 26 ft.

CASING RECORD:

8 inch

FINISH:

AQUIFERS:

WATER LEVEL:	16.07'	(7-25-57)	Ppg - 24 - 59pm	SPRINKLERS
12.22 ft.	12.22'	(9-24-57)	STATIC	
	15.36'	(6-17-58)	Ppg -	

PUMPING EQUIPMENT: Type Centrifugal H.P. 15
Capacity 250 G.P.M.

WELL TESTS:

Drawdown	10	ft. after	hours	250	G.P.M.
Drawdown		ft. after	hours		G.P.M.

USE OF WATER Irrigation Temp. °F. 19

SOURCE OF INFORMATION G.R. Record

DRILLER or DIGGER

ADDITIONAL DATA:

Log Water Level Measurements Chemical Analysis Aquifer Test

REMARKS:

Log: Dirt 0 to 2 ft.
Sand & gravel 2 to 26 ft.

Irrigation of 30 ft.