

STATE ENGINEER  
Salem, Oregon

MARION  
1934

# Well Record

STATE WELL NO. 10/2W-18G(1)  
COUNTY Marion  
APPLICATION NO. GR-1000

GR- 966

OWNER: Charles C. Hart Jr.

MAILING ADDRESS: Rt. 1, Box 222


LOCATION OF WELL: Owner's No. #1

CITY AND STATE: Jefferson, Oregon

SW 1/4 NE 1/4 Sec. 18 T. 10 S. R. 2 W., W.M.

Bearing and distance from section or subdivision

corner 2560' W. & 1400' S. of NE cor. Sec. 18.

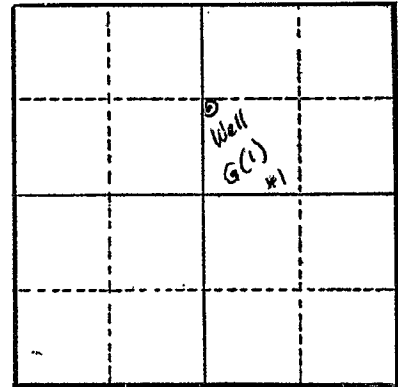

Section 18

Altitude at well 250 ft.

TYPE OF WELL: Drilled Date Constructed 1934

Depth drilled 16 ft. Depth cased 16 ft.

### CASING RECORD:

8 inch

### FINISH:

### AQUIFERS:

### WATER LEVEL:

12 ft. 8.27' (9-24-57)

PUMPING EQUIPMENT: Type Centrifugal H.P. 10

Capacity 200 G.P.M.

### WELL TESTS:

Drawdown 0.5 ft. after 200 hours G.P.M.

Drawdown ft. after hours G.P.M.

USE OF WATER Irrigation Temp. °F. 19

SOURCE OF INFORMATION G.B. Record

DRILLER or DIGGER Warnen

### ADDITIONAL DATA:

Log Water Level Measurements Chemical Analysis Aquifer Test

### REMARKS:

Log: Dirt 0 to 6 ft.  
Gravel & sand 6 to 16 ft.

Irrigation of 25 acres.