

STATE ENGINEER
Salem, Oregon

16/15
MARI...

Well Record

STATE WELL NO. 10/2W-18G(2)
COUNTY Marion
APPLICATION NO. GR-1001

GR- 967

OWNER: Charles S Hart Jr.

MAILING ADDRESS: Rt. 1, Box 222


LOCATION OF WELL: Owner's No. #2

CITY AND STATE: Jefferson, Oregon

SW 1/4 NE 1/4 Sec. 18 T. 10 S., R. 2 W., W.M.

Bearing and distance from section or subdivision

corner 1940' S. & 450' E. from NE 1/4 cor. Sec. 18.

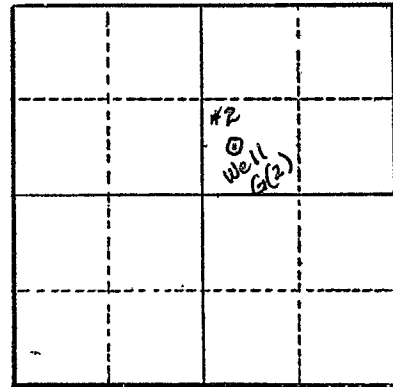

Section 18

Altitude at well 246 ft.

TYPE OF WELL: Drilled Date Constructed 1952

Depth drilled 20 ft. Depth cased 20 ft.

CASING RECORD:

6 inch.

FINISH:

AQUIFERS:

WATER LEVEL: 8.67' (7-25-57) Ppg - 46 - 59pm sprinklers
 6 ft. 7.93' (9-24-57) STATIC
 6.92' (6-17-58) " "

PUMPING EQUIPMENT: Type Centrifugal H.P. 10
Capacity 200 G.P.M.

WELL TESTS:

Drawdown 0.5 ft. after 180 hours G.P.M.
 Drawdown ft. after hours G.P.M.

USE OF WATER Irrigation Temp. °F. 19

SOURCE OF INFORMATION G.R. Record

DRILLER or DIGGER

ADDITIONAL DATA:

Log Water Level Measurements Chemical Analysis Aquifer Test

REMARKS:

Log: Dirt 0 to 6 ft.
 Sand & gravel 6 to 16 ft.

Irrigation of 20 acres.