

STATE ENGINEER
Salem, Oregon

Well
MARI.....

Well Record

STATE WELL NO. 10/2W-18M
COUNTY MARION
APPLICATION NO. GR-289Z

OWNER: Mr. & Mrs. Herman Kieper

MAILING ADDRESS: Jefferson, Oregon


LOCATION OF WELL: Owner's No. #1

CITY AND STATE:

NW 1/4 SW 1/4 Sec. 18 T. 10 S., R. 2 W., W.M.

Bearing and distance from section or subdivision

corner 450' W. and 3700' N.

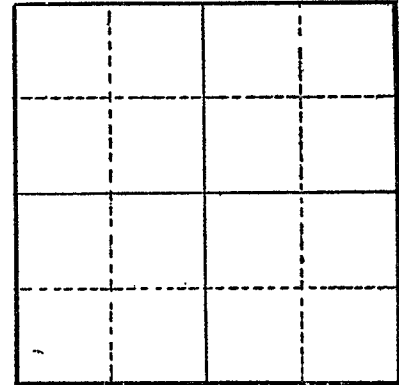

Section

Altitude at well

TYPE OF WELL: drilled Date Constructed 1950

Depth drilled 32 Depth cased 32

CASING RECORD:

8-inch

FINISH:

Perforated

AQUIFERS:

Gravel

WATER LEVEL:

20-feet

PUMPING EQUIPMENT: Type Centrifugal H.P. 20
Capacity 400 G.P.M.

WELL TESTS:

Drawdown 6 ft. after hours Pumping 400 G.P.M.
Drawdown ft. after hours G.P.M.

USE OF WATER irrigation Temp. °F. 19

SOURCE OF INFORMATION GR-2721

DRILLER or DIGGER

ADDITIONAL DATA:

Log Water Level Measurements Chemical Analysis Aquifer Test

REMARKS:

Gravel