

STATE ENGINEER
Salem, Oregon

Well Record

STATE WELL NO. 10/2W-18M
COUNTY Marion
APPLICATION NO. GR-1754

GR- 1701

OWNER: Yancy McGill

MAILING

ADDRESS: Rt. 1, Box 117

LOCATION OF WELL: Owner's No.

CITY AND

STATE: Turner, Oregon

NW 1/4 SW 1/4 Sec. 18 T. 10 S., R. 2 W., W.M.

Bearing and distance from section or subdivision

corner 750' S. & 400' E. from W 1/4 cor. Sec. 18


Altitude at well 250'

TYPE OF WELL: Drilled Date Constructed 1937

Depth drilled 21' Depth cased 21'

CASING RECORD:

8"

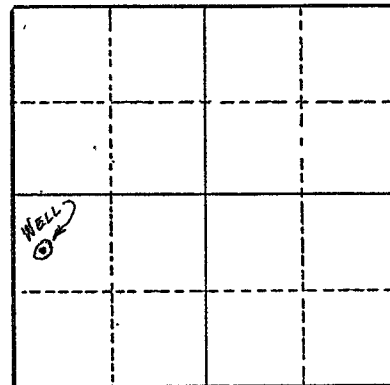

Section 18

FINISH:

AQUIFERS:

WATER LEVEL:

15'

PUMPING EQUIPMENT: Type 1 1/2" Cent. H.P. 5

Capacity 100 G.P.M.

WELL TESTS:

Drawdown ft. after hours G.P.M.

Drawdown ft. after hours G.P.M.

USE OF WATER Irrigation Temp. °F. 19

SOURCE OF INFORMATION GR Record

DRILLER or DIGGER Marion West

ADDITIONAL DATA:

Log N.A. Water Level Measurements Chemical Analysis Aquifer Test

REMARKS:

Irrigation of 6 acres.