

STATE ENGINEER
Salem, Oregon

11/21/71
MAKING...

Well Record

STATE WELL NO. 10/2W-19C
COUNTY Marion
APPLICATION NO. GR-3742

OWNER: Harvey Mitchell


MAILING ADDRESS: Route 1

LOCATION OF WELL: Owner's No. 8

CITY AND STATE: Jefferson, Oregon

NE 1/4 NW 1/4 Sec. 19 T. 10 N. S., R. 2 E. W., W.M.

Bearing and distance from section or subdivision corner starting at NW Corner, Section 19
West 176 feet thence South 45° West 788 feet

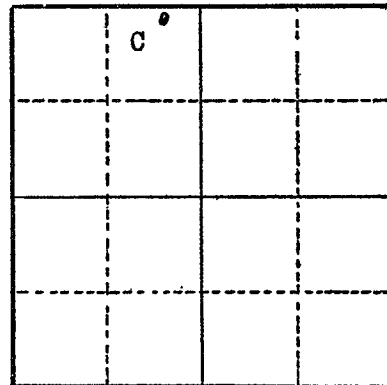

Section 19

Altitude at well 226 feet

TYPE OF WELL: Drilled Date Constructed 1951

Depth drilled 25 feet Depth cased _____

CASING RECORD:

10-inch casing

FINISH:

AQUIFERS:

WATER LEVEL:

9 feet

PUMPING EQUIPMENT: Type Pierce H.P. _____
Capacity _____ G.P.M.

WELL TESTS:
Drawdown 8 ft. after _____ hours 600 G.P.M.
Drawdown _____ ft. after _____ hours _____ G.P.M.

USE OF WATER Irrigation Temp. _____ °F. _____, 19____

SOURCE OF INFORMATION GR-4149
DRILLER or DIGGER Bill Hamilton, Albany

ADDITIONAL DATA:
Log (NA) Water Level Measurements _____ Chemical Analysis _____ Aquifer Test _____

REMARKS: