

STATE ENGINEER
Salem, Oregon

MAR 21.....
16202

Well Record

STATE WELL NO. 10/3W-2L(1)
COUNTY Marion
APPLICATION NO. GR- 246

OWNER: Forrest H. Miller

MAILING ADDRESS:


LOCATION OF WELL: Owner's No. 3

CITY AND STATE: Jefferson, Oregon

NE 1/4 SW 1/4 Sec. 2 T. 10 S., R. 3 W., W.M.

Bearing and distance from section or subdivision

corner S.21°56'E. 3791.39' from NW cor. of sec. 2

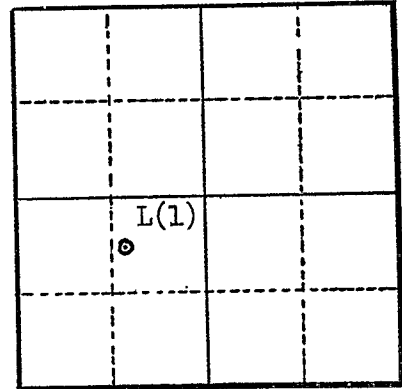

Altitude at well 275'

TYPE OF WELL: Drilled Date Constructed 7/1/38

Depth drilled 25' Depth cased 25'

Section 2

CASING RECORD:
8 inch

FINISH:

AQUIFERS:

WATER LEVEL:
15 feet

PUMPING EQUIPMENT: Type Allis Chalmers, centrifugal H.P. 15
Capacity 400 G.P.M.

WELL TESTS:
Drawdown ft. after hours G.P.M.
Drawdown ft. after hours G.P.M.

USE OF WATER Irrigation Temp. °F., 19

SOURCE OF INFORMATION GR- 222

DRILLER or DIGGER

ADDITIONAL DATA:

Log Water Level Measurements Chemical Analysis Aquifer Test

REMARKS:

Sandy loam 0 to 15
Gravel 15 to 25