

STATE ENGINEER
Salem, Oregon

116203
MARI.....

Well Record

STATE WELL NO. 10/3W-2M(1)
COUNTY Marion
APPLICATION NO. GR- 246

OWNER: Forrest H. Miller


MAILING
ADDRESS:

LOCATION OF WELL: Owner's No. 2

CITY AND STATE: Jefferson, Oregon

NW 1/4 SW 1/4 Sec. 2 T. 10 S., R. 3 W., W.M.

Bearing and distance from section or subdivision
corner 3428.91' S. 5°18'E. from NW cor. of sec. 2

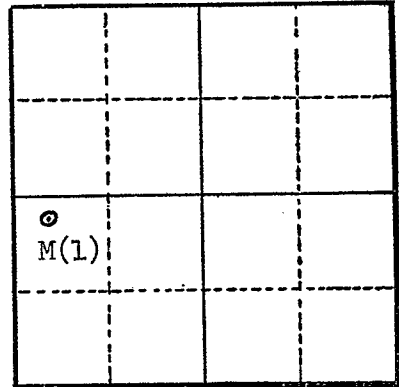

Altitude at well 275'

TYPE OF WELL: Drilled Date Constructed 7/15/40

Depth drilled 30' Depth cased 30'

Section 2

CASING RECORD:
8 inch

FINISH:

AQUIFERS:

WATER LEVEL:
15 feet

PUMPING EQUIPMENT: Type Allis Chalmers, centrifugal H.P. 15
Capacity 400 G.P.M.

WELL TESTS:
Drawdown ft. after hours G.P.M.
Drawdown ft. after hours G.P.M.

USE OF WATER Irrigation Temp. °F., 19

SOURCE OF INFORMATION GR- 222

DRILLER or DIGGER ?

ADDITIONAL DATA:
Log Water Level Measurements Chemical Analysis Aquifer Test

REMARKS:

Sandy loam 0 to 15
Gravel 15 to 25