

STATE ENGINEER  
Salem, Oregon

MARION  
10205

# Well Record

STATE WELL NO. 10/3W-3A(1)  
COUNTY Marion  
APPLICATION NO. GR- 403

OWNER: Dale L. Turnidge


MAILING ADDRESS: Rt. 1

LOCATION OF WELL: Owner's No. 1

CITY AND STATE: Jefferson, Oregon

NE 1/4 NE 1/4 Sec. 3 T. 10 S. R. 3 W., W.M.

Bearing and distance from section or subdivision corner 650' W. & 20' S. of NE cor. of sec. 3

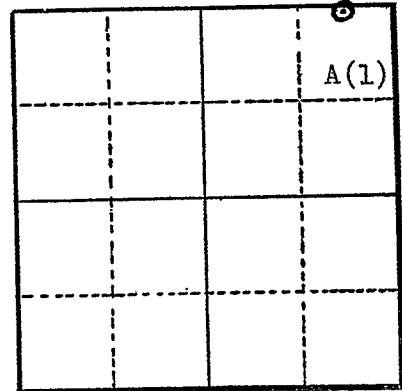

Section 3

Altitude at well 225'

TYPE OF WELL: Drilled Date Constructed 1946

Depth drilled 40' Depth cased 40'

### CASING RECORD:

12 inch set from 0 to 40 feet

### FINISH:

8"x $\frac{1}{2}$ " torch perforations set from 32 to 40 feet

### AQUIFERS:

Sand & gravel from 0 to 40 feet

### WATER LEVEL:

16 feet below land surface

PUMPING EQUIPMENT: Type F. M. 3"x4" centrifugal H.P. 15  
Capacity 450 G.P.M.

### WELL TESTS:

Drawdown ft. after hours G.P.M.  
Drawdown ft. after hours G.P.M.

USE OF WATER Irrigation (74.75 acres) Temp. °F. 19

SOURCE OF INFORMATION GR- 386

DRILLER or DIGGER

### ADDITIONAL DATA:

Log  Water Level Measurements Chemical Analysis Aquifer Test

### REMARKS:

Sand & gravel 0 to 40