

STATE ENGINEER
Salem, Oregon

Well Record

STATE WELL NO. 10/3W-3A(3)
COUNTY Marion
APPLICATION NO. GR- 403

MARI...
16207

OWNER: Dale L. Turnidge


MAILING ADDRESS: Rt. 1

LOCATION OF WELL: Owner's No. 3

CITY AND STATE: Jefferson, Oregon

NE 1/4 NE 1/4 Sec. 3 T. 10 S., R. 3 W., W.M.

Bearing and distance from section or subdivision corner 650' W. & 1125' S. of NE cor. of sec. 3

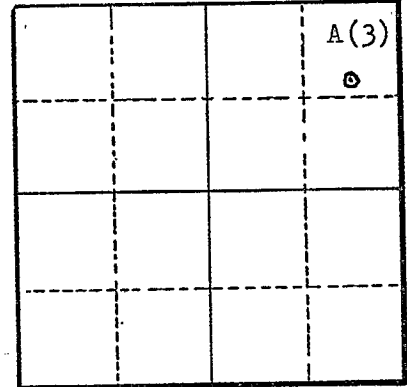

Section 3

Altitude at well 225'

TYPE OF WELL: Drilled Date Constructed 1946

Depth drilled 36' Depth cased 36'

CASING RECORD:

12 inch

FINISH:

Torch cut slots - 1/4 ft. (8"x1/2") set from 30 to 36 feet

AQUIFERS:

Sand & gravel from 8 to 36 feet

WATER LEVEL:

16 feet

PUMPING EQUIPMENT: Type F. M., 2"x3" centrifugal H.P. 7 1/2
Capacity 225 G.P.M.

WELL TESTS:

Drawdown ft. after hours G.P.M.
Drawdown ft. after hours G.P.M.

USE OF WATER Irrigation (74.75 acres) Temp. °F., 19.

SOURCE OF INFORMATION GR- 386

DRILLER or DIGGER

ADDITIONAL DATA:

Log Water Level Measurements Chemical Analysis Aquifer Test

REMARKS:

Sandy loam 0 to 8
Sand & gravel 8 to 36