

STATE ENGINEER
Salem, Oregon

MARI-16208

Well Record

STATE WELL NO. 10/3W-3B(1)
COUNTY Marion
APPLICATION NO. GR-404

OWNER: Dale L. Turnidge


MAILING ADDRESS: Rt. 1

LOCATION OF WELL: Owner's No. 7

CITY AND STATE: Jefferson, Oregon

NW 1/4 NE 1/4 Sec. 3 T. 10 S., R. 3 W., W.M.

Bearing and distance from section or subdivision corner 1025' S. & 1900' W. of NE cor. of sec. 3

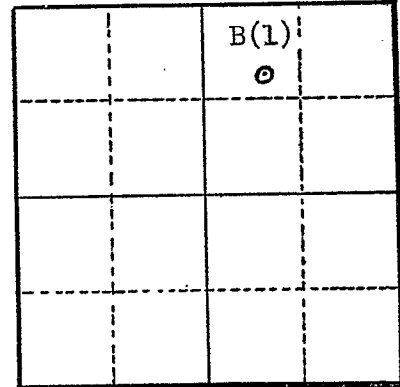

Altitude at well 225'

TYPE OF WELL: Drilled Date Constructed 1936

Depth drilled 40' Depth cased 40'

Section 3

CASING RECORD:
8 inch

FINISH: Torch cut slots - 1/4 ft. (8"x1/2") from 32 to 40 feet

AQUIFERS:
Sand & gravel from 2 to 40 feet

WATER LEVEL:
16 feet

PUMPING EQUIPMENT: Type H.P.
Capacity G.P.M.

WELL TESTS:
Drawdown ft. after hours G.P.M.
Drawdown ft. after hours G.P.M.

USE OF WATER Irrigation (89 acres) Temp. °F., 19.....
SOURCE OF INFORMATION GR-387

DRILLER or DIGGER
ADDITIONAL DATA:
Log NA Water Level Measurements Chemical Analysis Aquifer Test

REMARKS: