

STATE ENGINEER  
Salem, Oregon

# Well Record

STATE WELL NO. 10/3W-3F(1)  
COUNTY Marion  
APPLICATION NO. GR- 497

MARION  
Hood

OWNER: Jack L. Stiles


MAILING ADDRESS: 290 Delmar Dr.

LOCATION OF WELL: Owner's No. 3

CITY AND STATE: Salem, Oregon

SE 1/4 NW 1/4 Sec. 3 T. 10 S., R. 3 W., W.M.

Bearing and distance from section or subdivision corner On western boundary of DIC #67

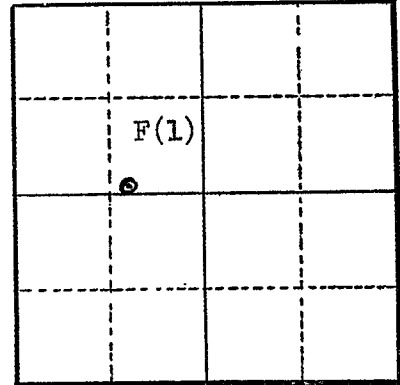

Section 3

Altitude at well \_\_\_\_\_

TYPE OF WELL: Drilled Date Constructed 1951

Depth drilled 22' Depth cased 22'

CASING RECORD:  
10 inch

FINISH:  
Torch cut slots from 15 to 22 feet

AQUIFERS:  
Gravel from 10 to 22 feet

WATER LEVEL:  
15 feet

PUMPING EQUIPMENT: Type Pacific, 2"x3" H.P. 10  
Capacity \_\_\_\_\_ G.P.M.

WELL TESTS:  
Drawdown 0 ft. after \_\_\_\_\_ hours 250 G.P.M.  
Drawdown \_\_\_\_\_ ft. after \_\_\_\_\_ hours \_\_\_\_\_ G.P.M.

USE OF WATER Irrigation (14 acres) Temp. \_\_\_\_\_ °F. \_\_\_\_\_, 19\_\_\_\_

SOURCE OF INFORMATION GR- 476

DRILLER or DIGGER \_\_\_\_\_

ADDITIONAL DATA:  
Log  Water Level Measurements \_\_\_\_\_ Chemical Analysis \_\_\_\_\_ Aquifer Test \_\_\_\_\_

REMARKS:

Soil, Newberg 0 to 10  
Gravel 10 to 22