

STATE ENGINEER
Salem, Oregon

~~10221~~
MARI
10211

Well Record

STATE WELL NO. 10/3W-3H(1)
COUNTY Marion
APPLICATION NO. GR-483

OWNER: Albert & Ilene Gurgarich


MAILING ADDRESS: Rt. 1 Box 187

LOCATION OF WELL: Owner's No. _____

CITY AND STATE: Jefferson, Oregon

SE 1/4 NE 1/4 Sec. 3 T. 10 S., R. 3 W., W.M.

Bearing and distance from section or subdivision corner 448' E. & 2563' N. to NE cor. of sec. 3

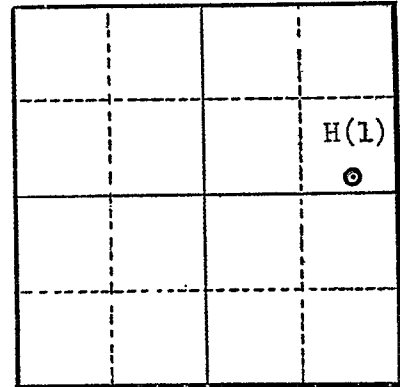

Altitude at well _____

TYPE OF WELL: Drilled Date Constructed 7/14/45

Depth drilled 32' Depth cased 32'

Section 3

CASING RECORD:
10 inch

FINISH: 3"x1/2" perforations set 10/ft. from 20 to 30 feet

AQUIFERS:
Gravel from 15 to 32 feet

WATER LEVEL:
13 feet

PUMPING EQUIPMENT: Type Pacific, centrifugal 3"x1" H.P. 20
Capacity 500 G.P.M.

WELL TESTS:
Drawdown 0? ft. after _____ hours 500 G.P.M.
Drawdown _____ ft. after _____ hours _____ G.P.M.

USE OF WATER Irrigation (52.90 acres) Temp. _____ °F. _____, 19____

SOURCE OF INFORMATION GR-465

DRILLER or DIGGER _____

ADDITIONAL DATA:
Log X Water Level Measurements _____ Chemical Analysis _____ Aquifer Test _____

REMARKS:
Sandy loam 0 to 15
Gravel, water bearing 15 to 32