

STATE ENGINEER
Salem, Oregon

MAR 16 2 13

Well Record

STATE WELL NO. 10/3W-3K(1)
COUNTY Marion
APPLICATION NO. GR-404

OWNER: Dale L. Turnidge


MAILING ADDRESS: Rt. 1

LOCATION OF WELL: Owner's No. 8

CITY AND STATE: Jefferson, Oregon

NW $\frac{1}{4}$ SE $\frac{1}{4}$ Sec. 3 T. 10 S., R. 3 W., W.M.

Bearing and distance from section or subdivision corner 3280' S. & 1975' W. of NE cor. of sec. 3

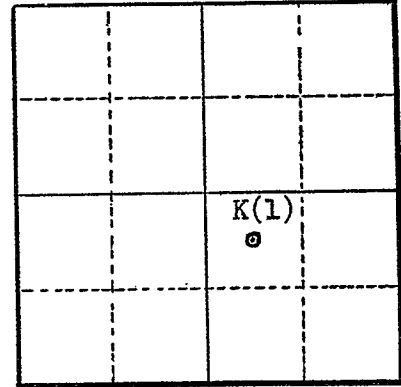

Altitude at well 195'

TYPE OF WELL: Drilled Date Constructed 1954

Depth drilled 30' Depth cased 30'

Section 3

CASING RECORD:
10 inch

FINISH:

Torch cut slots (8"x $\frac{1}{2}$ ") set 4/ft. from 24 to 30 feet

AQUIFERS:

Sand & gravel from 0 to 30 feet

WATER LEVEL:

16 feet

PUMPING EQUIPMENT: Type F. M.

H.P. 10

Capacity 250 G.P.M.

WELL TESTS:

Drawdown _____ ft. after _____ hours _____ G.P.M.

Drawdown _____ ft. after _____ hours _____ G.P.M.

USE OF WATER Irrigation (60.5 acres) Temp. _____ °F. _____, 19_____

SOURCE OF INFORMATION GR-387

DRILLER or DIGGER _____

ADDITIONAL DATA:

Log Water Level Measurements _____ Chemical Analysis _____ Aquifer Test _____

REMARKS:

Sand & gravel 0 to 30