

STATE ENGINEER  
Salem, Oregon

MARI...  
16214

# Well Record

STATE WELL NO. 10/3W-3L(1)  
COUNTY Marion  
APPLICATION NO. GR-497

OWNER: Jack L. Stiles


MAILING ADDRESS: 290 Delmar Dr.

LOCATION OF WELL: Owner's No. 2

CITY AND STATE: Salem, Oregon

NE 1/4 SW 1/4 Sec. 3 T. 10 S., R. 3 W., W.M.

Bearing and distance from section or subdivision corner West boundary line of DLC #67

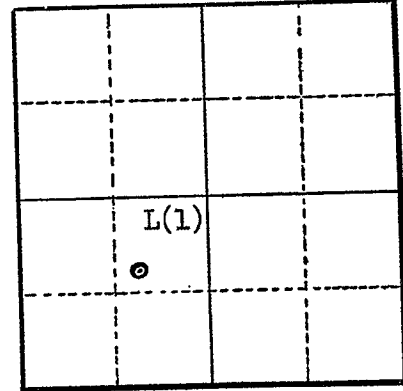

Section 3

Altitude at well

TYPE OF WELL: Drilled Date Constructed 4/1/53

Depth drilled 22' Depth cased 22'

CASING RECORD:  
10 inch

FINISH: Torch cut slots from 15 to 22 feet

AQUIFERS:  
Gravel from 10 to 22 feet

WATER LEVEL:  
15 feet

PUMPING EQUIPMENT: Type Pico 2"x3" H.P. 7 1/2  
Capacity ? 250 G.P.M.

WELL TESTS:  
Drawdown 0 ft. after 250 hours G.P.M.  
Drawdown ft. after hours G.P.M.

USE OF WATER Irrigation (14 acres) Temp. °F., 19

SOURCE OF INFORMATION GR-476

DRILLER or DIGGER Myron West

ADDITIONAL DATA:  
Log  Water Level Measurements Chemical Analysis Aquifer Test

### REMARKS:

Soil, Newberg 0 to 10  
Gravel 10 to 22