

STATE ENGINEER
Salem, Oregon

*MARI...
11015*

Well Record

STATE WELL NO. 10/3W-3P(1)
COUNTY Marion
APPLICATION NO. GR-497

OWNER: Jack L. Stiles


MAILING ADDRESS: 290 Delmar Dr.

LOCATION OF WELL: Owner's No. 1

CITY AND STATE: Salem, Oregon

SE 1/4 SW 1/4 Sec. 3 T. 10 S., R. 3 W., W.M.

Bearing and distance from section or subdivision corner West line of DLC #67

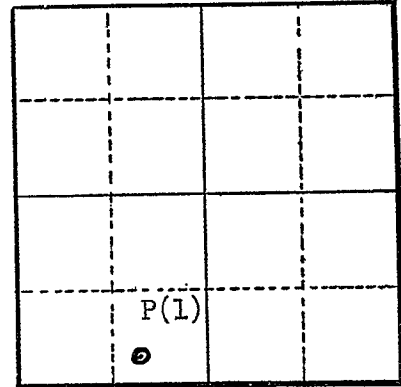

Altitude at well

TYPE OF WELL: Drilled Date Constructed 1945

Depth drilled 22' Depth cased 22'

Section 3

CASING RECORD:
10 inch

FINISH:

Torch cut slots from 15 to 22 feet

AQUIFERS:

Gravel from 10 to 22 feet

WATER LEVEL:

15 feet

PUMPING EQUIPMENT: Type Pacific 2"x3" H.P. 10
Capacity 250 G.P.M.

WELL TESTS:

Drawdown - ft. after 250 hours G.P.M.
Drawdown ft. after hours G.P.M.

USE OF WATER Irrigation (12 acres) Temp. °F., 19

SOURCE OF INFORMATION GR-476

DRILLER or DIGGER

ADDITIONAL DATA:

Log X Water Level Measurements Chemical Analysis Aquifer Test

REMARKS:

Soil, Newberg 0 to 10
Gravel 10 to 22