

STATE ENGINEER
Salem, Oregon

MAR 16 1951

Well Record

STATE WELL NO. 10/3W-3R(1)
COUNTY Marion
APPLICATION NO. GR- 246

OWNER: Forrest H. Miller


MAILING ADDRESS: _____

LOCATION OF WELL: Owner's No. 4

CITY AND STATE: Jefferson, Oregon

SE 1/4 SE 1/4 Sec. 3 T. 10 S., R. 3 W., W.M.

Bearing and distance from section or subdivision corner 4376.13' S. 9°33'W. of NW cor. of sec. 2

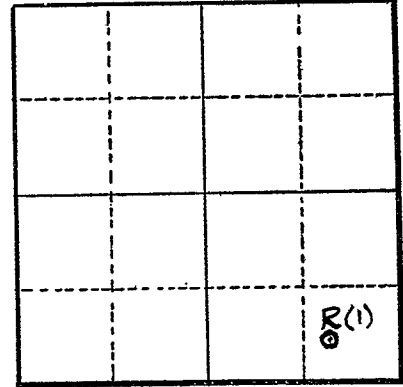

Altitude at well 275'

TYPE OF WELL: Drilled Date Constructed 10/16/51

Depth drilled 30' Depth cased 30'

Section 3

CASING RECORD:
10 inch

FINISH:

AQUIFERS:

WATER LEVEL:
12 feet

PUMPING EQUIPMENT: Type Allis Chalmers, centrifugal H.P. 15
Capacity 400 G.P.M.

WELL TESTS:
Drawdown _____ ft. after _____ hours _____ G.P.M.
Drawdown _____ ft. after _____ hours _____ G.P.M.

USE OF WATER Irrigation Temp. _____ °F. _____, 19_____

SOURCE OF INFORMATION GR- 222

DRILLER or DIGGER _____

ADDITIONAL DATA:
Log X Water Level Measurements _____ Chemical Analysis _____ Aquifer Test _____

REMARKS:

Sandy loam 0 to 15
Gravel, WB 15 to 30