

STATE ENGINEER
Salem, Oregon

MARION 16240

Well Record

STATE WELL NO. 10/3W-12N
COUNTY MARION
APPLICATION NO. GR-2492

OWNER: Nettie M. Hawk, City Recorder


MAILING ADDRESS: Box 125

LOCATION OF WELL: Owner's No. #2

CITY AND STATE: Jefferson, Oregon

SW 1/4 SW 1/4 Sec. 12 T. 10 S., R. 3 W., W.M.

Bearing and distance from section or subdivision corner 750' E. & 250' N.

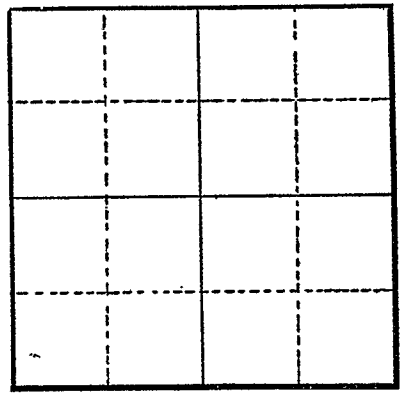

Section

Altitude at well

TYPE OF WELL: Drilled Date Constructed 1940

Depth drilled 40 Depth cased

CASING RECORD:

FINISH:

AQUIFERS:

WATER LEVEL:

PUMPING EQUIPMENT: Type Turbine H.P. 15
Capacity 100 G.P.M.

WELL TESTS:
Drawdown ft. after hours G.P.M.
Drawdown ft. after hours G.P.M.

USE OF WATER City Consumption Temp. °F., 19
SOURCE OF INFORMATION GR-2359

DRILLER or DIGGER
ADDITIONAL DATA:
Log Water Level Measurements Chemical Analysis Aquifer Test

REMARKS: