

STATE ENGINEER
Salem, Oregon

MARI.....
16241

Well Record

STATE WELL NO. 10/3W-12N
COUNTY MARION
APPLICATION NO. GR-2491

OWNER: Nettie M. Hawk, City Recorder


MAILING ADDRESS: _____

LOCATION OF WELL: Owner's No. #1

CITY AND STATE: Jefferson, Oregon

SW 1/4 SW 1/4 Sec. 12 T. 10 S., R. 3 W., W.M.

Bearing and distance from section or subdivision corner 750' E. and 275' N.

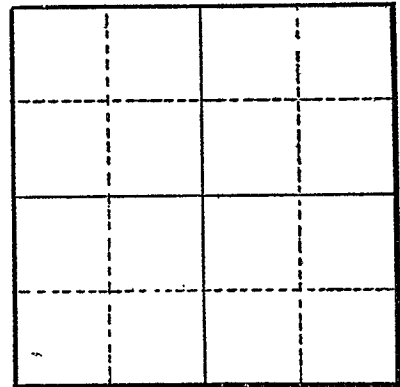

Section _____

Altitude at well _____

TYPE OF WELL: Drilled Date Constructed 1938

Depth drilled 38 Depth cased 38

CASING RECORD:

8-inch

FINISH:

Perforated

AQUIFERS:

WATER LEVEL:

PUMPING EQUIPMENT: Type Turbine H.P. 10
Capacity 100 G.P.M.

WELL TESTS:

Drawdown _____ ft. after _____ hours _____ G.P.M.
Drawdown _____ ft. after _____ hours _____ G.P.M.

USE OF WATER City Consumption Temp. _____ °F. _____, 19

SOURCE OF INFORMATION GR-2358

DRILLER or DIGGER R. A. West, Salem, Oregon

ADDITIONAL DATA:

Log _____ Water Level Measurements _____ Chemical Analysis _____ Aquifer Test _____

REMARKS: