

STATE ENGINEER
Salem, Oregon

MARI...
1624

Well Record

STATE WELL NO. 10/3W-12N
COUNTY MARION
APPLICATION NO. GR-2493

OWNER: Nettie M. Hawk, City Recorder


MAILING ADDRESS: _____

LOCATION OF WELL: Owner's No. #3

CITY AND STATE: Jefferson, Oregon

SW 1/4 SW 1/4 Sec. 12 T. 10 S., R. 3 W., W.M.

Bearing and distance from section or subdivision corner 750' E. & 200' N.

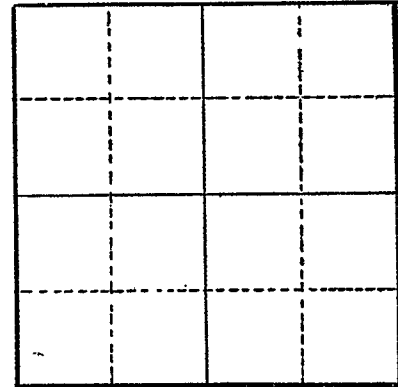

Section _____

Altitude at well _____

TYPE OF WELL: Drilled Date Constructed 1951

Depth drilled 127 Depth cased _____

CASING RECORD:

10-inch

FINISH:

AQUIFERS:

Sand, Gravel, rock, and shale

WATER LEVEL:

PUMPING EQUIPMENT: Type Turbine H.P. 20
Capacity 250 G.P.M.

WELL TESTS:

Drawdown _____ ft. after _____ hours _____ G.P.M.
Drawdown _____ ft. after _____ hours _____ G.P.M.

USE OF WATER City Consumption Temp. _____ °F., 19
SOURCE OF INFORMATION GR-2360

DRILLER or DIGGER _____

ADDITIONAL DATA:

Log Water Level Measurements _____ Chemical Analysis _____ Aquifer Test _____

REMARKS:

- 0 - 33 Sand and gravel formation
- 33 - 65 Soft shale
- 65 - 120 Hard sedimentary rock
- 120 - 124 Hard shale

Perforation at water formation 24 30

Well was cased through rock under-reaming to 10-inch Hole

Test 200 gpm from 117'