

STATE ENGINEER  
Salem, Oregon

MAX.....

16244

# Well Record

STATE WELL NO. 10/3W-120(1)  
COUNTY Marion  
APPLICATION NO. GR- 296

OWNER: Nobel D. Bradley


MAILING ADDRESS: Rt. 1 Box 205

LOCATION OF WELL: Owner's No. 1

CITY AND STATE: Jefferson, Oregon

SW 1/4 SE 1/4 Sec. 12 T. 10 S. R. 3 W., W.M.

Bearing and distance from section or subdivision corner N.89°51'W. 694.98' & N.17°24'E. 396' from SE cor. of J. Conser DLC #63

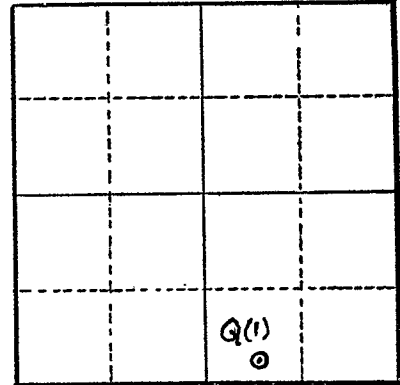

Section 12

Altitude at well 275'

TYPE OF WELL: Drilled Date Constructed 1953

Depth drilled 26' Depth cased 26'

CASING RECORD:  
10 inch

FINISH: 1/4" perforations set from 16 to 26 feet

AQUIFERS:  
Sand & gravel from 6 to 26 feet

WATER LEVEL: 8.37' (4-25-58)  
10 feet 7.74' (6-13-58)

PUMPING EQUIPMENT: Type Pacific, centrifugal H.P. 20  
Capacity 650 G.P.M.

WELL TESTS:  
Drawdown 10 ft. after 650 hours G.P.M.  
Drawdown ft. after hours G.P.M.

USE OF WATER Irrigation (80 acres) Temp. °F. 19

SOURCE OF INFORMATION GR- 276

DRILLER or DIGGER ?

ADDITIONAL DATA:  
Log X Water Level Measurements Chemical Analysis Aquifer Test

REMARKS:  
Dirt 0 to 6  
Silt & sand 6 to 12  
Gravel, fine 12 to 26