

STATE ENGINEER  
Salem, Oregon

**Well Record**  
MARION COUNTY  
11045


STATE WELL NO. 10/3W-12Q(2)  
COUNTY Marion  
APPLICATION NO. GR- 296

OWNER: Nobel D. Bradley  
MAILING ADDRESS: Rt. 1 Box 205

LOCATION OF WELL: Owner's No. 2  
CITY AND STATE: Jefferson, Oregon

SW 1/4 SE 1/4 Sec. 12 T. 10 S., R. 3 W., W.M.

Bearing and distance from section or subdivision  
corner N.89°51'W. 694.98' & N.17°24'E. 396' &  
N.75°38'E. 269.65' from SE cor. of J. Conser  
DLC #63.

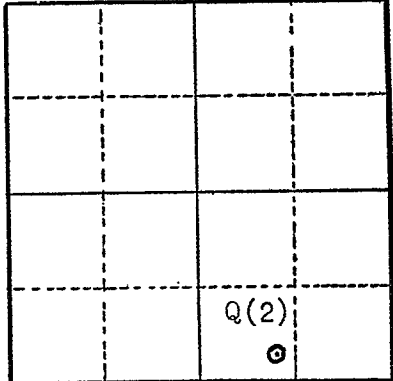

Altitude at well 275'

TYPE OF WELL: Drilled Date Constructed 1942

Depth drilled 22' Depth cased 22'

Section 12

CASING RECORD:  
6 inch

FINISH:  
1/4" perforations from 12 to 22 feet

AQUIFERS:  
Sand & gravel from 6 to 22 feet

WATER LEVEL: 8.16' (4-25-58)  
10 feet 9.40' (6-13-58)

PUMPING EQUIPMENT: Type Allis Chalmers, centrifugal H.P. 10  
Capacity 600 G.P.M.

WELL TESTS:  
Drawdown 10 ft. after 650 hours G.P.M.  
Drawdown ft. after hours G.P.M.

USE OF WATER Irrigation (80 acres) Temp. °F., 19  
SOURCE OF INFORMATION GR- 276

DRILLER or DIGGER  
ADDITIONAL DATA:  
Log X Water Level Measurements Chemical Analysis Aquifer Test

REMARKS:  
Dirt 0 to 6  
Silt & sand 6 to 12  
Sand & gravel 12 to 22