

STATE ENGINEER
Salem, Oregon

Well Record

STATE WELL NO. 10/3W-12R(1)
COUNTY Marion
APPLICATION NO. GR-1172

12. 11.11.11.11.11.11
Well

GR- 1133

OWNER: J. W. or Minnie Vasek


MAILING
ADDRESS:

LOCATION OF WELL: Owner's No.

CITY AND
STATE: Jefferson, Oregon

SE 1/4 SE 1/4 Sec. 12 T. 10 S., R. 3 W., W.M.

Bearing and distance from section or subdivision
corner 322' W. & 127' N. from SE cor. Sec. 12.

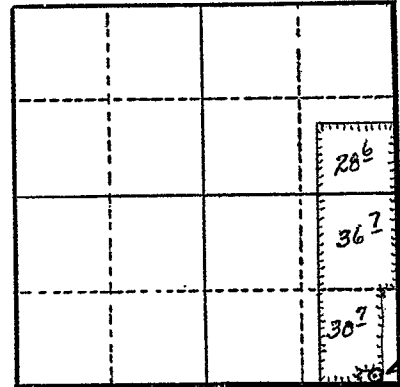

Altitude at well 240 ft.

TYPE OF WELL: Drilled Date Constructed 1954

Depth drilled 23 ft. Depth cased 23 ft.

Section 12

CASING RECORD:

10 inch

FINISH:

AQUIFERS:

WATER LEVEL: 9.59' (6-20-58)
13 ft.

PUMPING EQUIPMENT: Type 3 x 4 in. Cent. H.P. 25
Capacity 300 G.P.M.

WELL TESTS:

Drawdown 1 ft. after hours 500 G.P.M.
Drawdown ft. after hours G.P.M.

USE OF WATER Irrigation Temp. °F., 19.....

SOURCE OF INFORMATION G. R. Record

DRILLER or DIGGER Bill Hamilton

ADDITIONAL DATA:

Log Water Level Measurements Chemical Analysis Aquifer Test

REMARKS:

Log: Soil 0 to 6 ft.
Sand & gravel 6 to 14 ft.
Large gravel 14 to 23 ft.

Irrigation of 96 acres.