

STATE ENGINEER
Salem, Oregon

MARI.....
1616

Well Record

STATE WELL NO. 10/3W-13B
COUNTY MARION
APPLICATION NO. GR-4068

OWNER: G. T. Sheffield

MAILING ADDRESS: Rt 1 Box 291


LOCATION OF WELL: Owner's No. _____

CITY AND STATE: Jefferson, Oregon

NW 1/4 NE 1/4 Sec. 13 T. 10 S., R. 3 W., W.M.

Bearing and distance from section or subdivision

corner 879.98' W & 197' N of SE cor J. Conser DLC

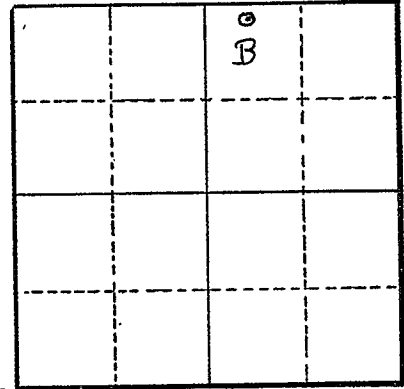

Section 13

Altitude at well _____

TYPE OF WELL: Dug Date Constructed 1951

Depth drilled 13' Depth cased 13'

CASING RECORD:

5-inch

FINISH:

AQUIFERS:

dirt & gravel

WATER LEVEL:

3'

PUMPING EQUIPMENT: Type Electric Pump H.P. 7 1/2
Capacity 100 G.P.M.

WELL TESTS:

Drawdown 10 ft. after _____ hours 300 G.P.M.

Drawdown _____ ft. after _____ hours _____ G.P.M.

USE OF WATER Irrigation Temp. _____ °F. _____, 19_____

SOURCE OF INFORMATION GR-3052 GR-3952

DRILLER or DIGGER self

ADDITIONAL DATA:

Log X Water Level Measurements _____ Chemical Analysis _____ Aquifer Test _____

REMARKS:

Dirt and gravel

0' to 13'