

STATE ENGINEER  
Salem, Oregon

Well Record

STATE WELL NO. 10/3W-13D(1)  
COUNTY Marion  
APPLICATION NO. GR- 160

OWNER: Harry M. Wall


MAILING  
ADDRESS:

LOCATION OF WELL: Owner's No. 1

CITY AND  
STATE: Jefferson, Oregon

NW ¼ NW ¼ Sec. 13 T. 10 S., R. 3 W., W.M.

Bearing and distance from section or subdivision  
corner 34.27 ch. E. of NW cor. of the T. Holt  
DLC #67, then S 7½ ch. + 1 rod to well.

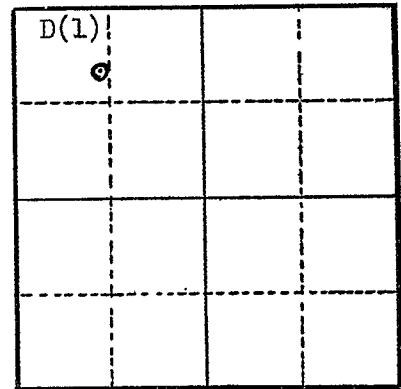

Altitude at well 227'

TYPE OF WELL: Drilled Date Constructed Sept. 1946

Depth drilled 25' Depth cased 25'

Section 13

CASING RECORD:  
8 inch

FINISH:  
½" perforations from 11 to 25 feet

AQUIFERS:  
River gravel from ? to 25 feet

WATER LEVEL:  
10 feet

PUMPING EQUIPMENT: Type F. M. 3 phase H.P. 7½  
Capacity 130 G.P.M.

WELL TESTS:  
Drawdown 5 ft. after 130 hours G.P.M.  
Drawdown ft. after hours G.P.M.

USE OF WATER Irrigation (6 acres) Temp. °F. 19  
SOURCE OF INFORMATION GR- 153  
DRILLER or DIGGER Marion West, Salem

ADDITIONAL DATA:  
Log X Water Level Measurements Chemical Analysis Aquifer Test

REMARKS:

Top soil 0 to ?  
Soil, sandy ??????  
Gravel, river ? to 25