

STATE ENGINEER
Salem, Oregon

1026A
MARI.....

Well Record

STATE WELL NO. 10/3W-13D(2)
COUNTY Marion
APPLICATION NO. GR- 207

OWNER: Leland W. Wells


MAILING ADDRESS:

LOCATION OF WELL: Owner's No. 1

CITY AND STATE: Jefferson, Oregon

NW 1/4 NW 1/4 Sec. 13 T. 10 S., R. 3 W., W.M.

Bearing and distance from section or subdivision corner 1000' S. & 750' E. from NW cor. of sec. 13

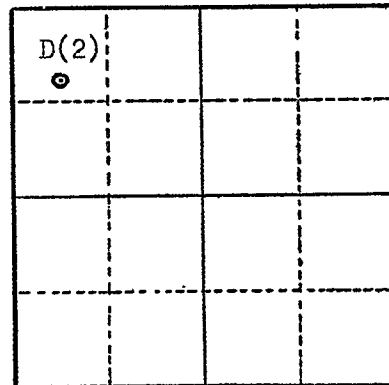

Section 13

Altitude at well 230'

TYPE OF WELL: Drilled Date Constructed June 1937

Depth drilled 30' Depth cased 30'

CASING RECORD:

8 inch

FINISH:

AQUIFERS:

WATER LEVEL: 17.40 (6-20-58) Ppg -
15 feet

PUMPING EQUIPMENT: Type Centrifugal H.P. 10
Capacity 300 G.P.M.

WELL TESTS:

Drawdown ft. after hours G.P.M.
Drawdown ft. after hours G.P.M.

USE OF WATER Irrigation (20 acres) Temp. °F., 19.....

SOURCE OF INFORMATION GR- 192

DRILLER or DIGGER Myron West

ADDITIONAL DATA:

Log NA Water Level Measurements Chemical Analysis Aquifer Test

REMARKS: