

STATE ENGINEER
Salem, Oregon

10270
MARI.....

Well Record

GR- 1628

STATE WELL NO. ...10/3W-13D...
COUNTY ...Marion...
APPLICATION NO. ...GR- 1679...

OWNER: Luella M. Moses


MAILING ADDRESS: 1155 Madison St.

LOCATION OF WELL: Owner's No.

CITY AND STATE: Salem, Oregon

NW 1/4 NW 1/4 Sec. 13 T. 10 S., R. 3 W., W.M.

Bearing and distance from section or subdivision corner 1089' E. & 990' S. from NW cor. Sec. 13

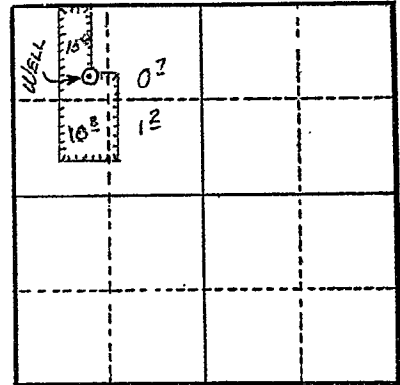

Section13.....

Altitude at well 200'

TYPE OF WELL: Drilled Date Constructed 1950

Depth drilled 24' Depth cased 24'

CASING RECORD:

8"

FINISH:

Perforated - 1" x 10" (5/ft.) from 16 to 24 ft.

AQUIFERS:

Gravel

WATER LEVEL:

17'

PUMPING EQUIPMENT: Type F. M. 2" Cent. H.P. 10

Capacity 216 G.P.M.

WELL TESTS:

Drawdown ft. after hours G.P.M.

Drawdown ft. after hours G.P.M.

USE OF WATER Irrigation Temp. °F. 19

SOURCE OF INFORMATION GR Record

DRILLER or DIGGER Marion West

ADDITIONAL DATA:

Log N.A. Water Level Measurements Chemical Analysis Aquifer Test

REMARKS:

Irrigation of 27.7 acres.