

STATE ENGINEER  
Salem, Oregon

*MAR 21 1950*  
*11070*

# Well Record

STATE WELL NO. 10/3W-13H(1)  
COUNTY Marion  
APPLICATION NO. GR-1176

GR- 1137

OWNER: Albert R. Arnold


MAILING ADDRESS: Rt. 1

LOCATION OF WELL: Owner's No. \_\_\_\_\_

CITY AND STATE: Jefferson, Oregon

SE ¼ NE ¼ Sec. 13 T. 10 S., R. 3 W., W.M.

Bearing and distance from section or subdivision corner 640' W. & 1600' S. from NE cor. Sec. 13.

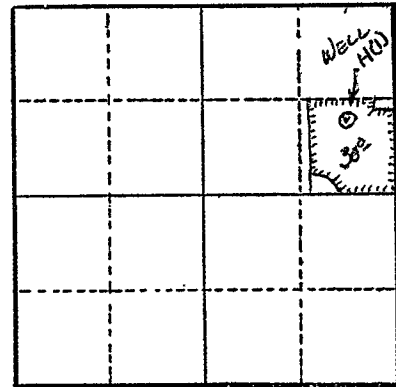

Section 13

Altitude at well 245 ft.

TYPE OF WELL: Drilled Date Constructed 1950

Depth drilled 20 ft. Depth cased 20 ft.

### CASING RECORD:

8 inch

### FINISH:

Perforated

### AQUIFERS:

### WATER LEVEL:

8 ft.

PUMPING EQUIPMENT: Type F. M. H.P. 15

Capacity 400 G.P.M.

### WELL TESTS:

Drawdown \_\_\_\_\_ ft. after \_\_\_\_\_ hours \_\_\_\_\_ G.P.M.

Drawdown \_\_\_\_\_ ft. after \_\_\_\_\_ hours \_\_\_\_\_ G.P.M.

USE OF WATER Irrigation Temp. \_\_\_\_\_ °F. \_\_\_\_\_, 19\_\_\_\_\_

SOURCE OF INFORMATION G.R. Record

DRILLER or DIGGER \_\_\_\_\_

### ADDITIONAL DATA:

Log N.A. Water Level Measurements \_\_\_\_\_ Chemical Analysis \_\_\_\_\_ Aquifer Test \_\_\_\_\_

### REMARKS:

Irrigation of 30 acres.