

STATE ENGINEER  
Salem, Oregon

MAR 1 1940  
16213

# Well Record

STATE WELL NO. 10/3W-13J(1)  
COUNTY Marion  
APPLICATION NO. GR- 97

OWNER: Robert S. Hart


MAILING ADDRESS:

LOCATION OF WELL: Owner's No. 1

CITY AND STATE: Jefferson, Oregon

NE 1/4 SE 1/4 Sec. 13 T. 10 S., R. 3 W., W.M.

Bearing and distance from section or subdivision corner 600' W. & 500' S. of E 1/4 cor. of sec. 13

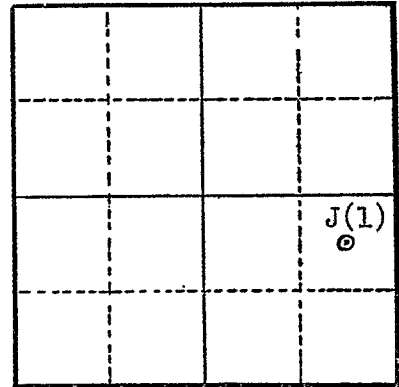

Section 13

Altitude at well 128'

TYPE OF WELL: Dug Date Constructed 1940

Depth drilled 15' Depth cased 15'

### CASING RECORD:

30 inch concrete tile

### FINISH:

### AQUIFERS:

Sand & gravel from 0 to 15 feet

WATER LEVEL: 8 feet  
11.40 (7-25-57) Pq-15 min. PD. 2'  
8.23 (6-20-58) STATIC

PUMPING EQUIPMENT: Type F. M. H.P. 20  
Capacity G.P.M.

WELL TESTS:  
Drawdown 3 ft. after 600 hours G.P.M.  
Drawdown ft. after hours G.P.M.

USE OF WATER Irrigation (45 acres) Temp. °F., 19

SOURCE OF INFORMATION GR- 93

DRILLER or DIGGER Owner

### ADDITIONAL DATA:

Log  Water Level Measurements Chemical Analysis Aquifer Test

### REMARKS:

Sand & gravel 0 to 15