

STATE ENGINEER
Salem, Oregon

MAR 1955

Well Record

STATE WELL NO. 10/3W-13K(1)
COUNTY Marion
APPLICATION NO. GR- 208

OWNER: Leland W. Wells


MAILING ADDRESS:

LOCATION OF WELL: Owner's No. 2

CITY AND STATE: Jefferson, Oregon

NW 1/4 SE 1/4 Sec. 13 T. 10 S. R. 3 W., W.M.

Bearing and distance from section or subdivision corner 900' S. & 500' E. from center of sec. 13

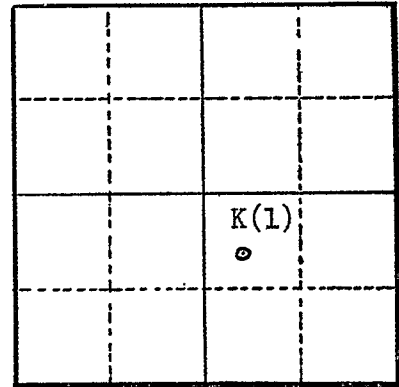

Section 13

Altitude at well 260'

TYPE OF WELL: Drilled Date Constructed 7/19/55

Depth drilled 26' Depth cased 26'

CASING RECORD:
8 inch

FINISH:

AQUIFERS:

WATER LEVEL: 12.92 (6-20-58) Ppg -
15 feet

PUMPING EQUIPMENT: Type Centrifugal H.P. 10
Capacity 300 G.P.M.

WELL TESTS:
Drawdown ft. after hours G.P.M.
Drawdown ft. after hours G.P.M.

USE OF WATER Irrigation (30 acres) Temp. °F. 19

SOURCE OF INFORMATION GR- 193

DRILLER or DIGGER Marion West

ADDITIONAL DATA:
Log NA Water Level Measurements Chemical Analysis Aquifer Test

REMARKS: