

STATE ENGINEER
Salem, Oregon

MAR 1 1945

Well Record

STATE WELL NO. 10/3W-13L
COUNTY Linn
APPLICATION NO. GR-1819

GR-1760

OWNER: Ezra C. Hart

MAILING ADDRESS: 1140 E. 2nd Ave.


LOCATION OF WELL: Owner's No. #1

CITY AND STATE: Albany, Oregon

NE 1/4 SW 1/4 Sec. 13 T. 10 S., R. 3 W., W.M.

Bearing and distance from section or subdivision

corner 200' E. & 100' S. from W¹ cor. Sec. 13

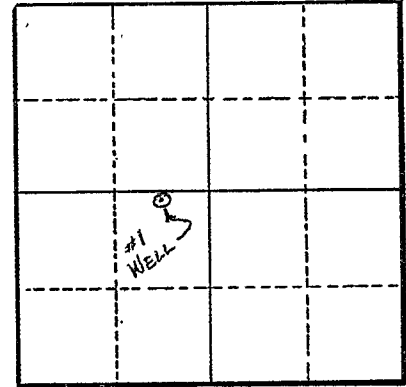

Section 13

Altitude at well

TYPE OF WELL: Driven Date Constructed 1945

Depth drilled 20' Depth cased 20'

CASING RECORD:

4"

FINISH:

?

AQUIFERS:

Sand & gravels

WATER LEVEL:

7'

PUMPING EQUIPMENT: Type F. M. Cent. H.P. 15

Capacity 250 G.P.M.

WELL TESTS:

Drawdown ft. after hours G.P.M.

Drawdown ft. after hours G.P.M.

USE OF WATER Irrigation Temp. °F. 19

SOURCE OF INFORMATION GR Record

DRILLER or DIGGER

ADDITIONAL DATA:

Log N.A. Water Level Measurements Chemical Analysis Aquifer Test

REMARKS:

Irrigation of 29.51 acres.