

STATE ENGINEER
Salem, Oregon

MAR 1958
14278

Well Record

STATE WELL NO. 10/3W-13-M(1)
COUNTY Marion
APPLICATION NO. GR-1218

GR- 1178

OWNER: Walter Glasgow

MAILING ADDRESS:

LOCATION OF WELL: Owner's No. #1


CITY AND STATE:

Jefferson, Oregon

NW ¼ SW ¼ Sec. 13 T. 10 S. R. 3 W., W.M.

Bearing and distance from section or subdivision

corner 2650' S. & 1300' E. from NW cor. Sec. 13.

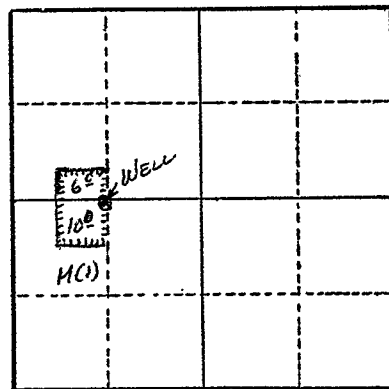

Section 13

Altitude at well 225 ft.

TYPE OF WELL: Drilled Date Constructed 1950??

Depth drilled 28 ft. Depth cased 28 ft.

CASING RECORD:

8 inch

FINISH:

Perforated from 16 to 28 ft.

AQUIFERS:

WATER LEVEL: 12.35' (6-17-58)
12 ft.

PUMPING EQUIPMENT: Type Pacific 2½ x 3 in. H.P. 10
Capacity 350 G.P.M.

WELL TESTS:

| | | | |
|----------|-----------|-------|--------|
| Drawdown | ft. after | hours | G.P.M. |
| Drawdown | ft. after | hours | G.P.M. |

USE OF WATER Irrigation Temp. °F. 19

SOURCE OF INFORMATION G. R. Record

DRILLER or DIGGER Orville West

ADDITIONAL DATA:

Log N.A. Water Level Measurements Chemical Analysis Aquifer Test

REMARKS:

Irrigation of 16 acres.