

STATE ENGINEER
Salem, Oregon

MAR 21 1945
11079

Well Record

STATE WELL NO. 10/3W-13M(2)
COUNTY Marion
APPLICATION NO. GR-1219

GR- 1179

OWNER: Walter Glasgow

MAILING ADDRESS:


LOCATION OF WELL: Owner's No. #2

CITY AND STATE: Jefferson, Oregon

NW ¼ SW ¼ Sec. 13 T. 10 S. R. 3 W., W.M.

Bearing and distance from section or subdivision

corner 3400' S. & 900' E. from NW cor. Sec. 13.

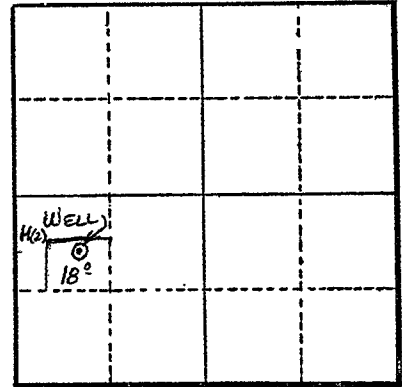

Section 13

Altitude at well 225 ft.

TYPE OF WELL: Drilled Date Constructed 1945

Depth drilled 32 ft. Depth cased 32 ft.

CASING RECORD:

8 inch

FINISH:

Perforated from 16 to 32 ft.

AQUIFERS:

WATER LEVEL: 14.08' (6-13-58) STATIC
14 ft. 16.22' (6-17-58) Ppg -

PUMPING EQUIPMENT: Type Pacific 2½ x 3 in. H.P. 10
Capacity 350 G.P.M.

WELL TESTS:

Drawdown ft. after hours G.P.M.
Drawdown ft. after hours G.P.M.

USE OF WATER Irrigation Temp. °F. 19

SOURCE OF INFORMATION G. R. Record

DRILLER or DIGGER Orville West

ADDITIONAL DATA:

Log N.A. Water Level Measurements Chemical Analysis Aquifer Test

REMARKS:

Irrigation of 18 acres.