

STATE ENGINEER
Salem, Oregon

Well Record

STATE WELL NO. 10/3W-13N
COUNTY Marion
APPLICATION NO. GR- 864

MARION
16082

OWNER: Ernest A. Perni


MAILING ADDRESS: Rt. 1 Box 198

LOCATION OF WELL: Owner's No. _____

CITY AND STATE: Jefferson, Oregon

SW $\frac{1}{4}$ SW $\frac{1}{4}$ Sec. 13 T. 10 S., R. 3 W., W.M.

Bearing and distance from section or subdivision
corner 1200' N. & 300' E. from SW cor. of sec. 13

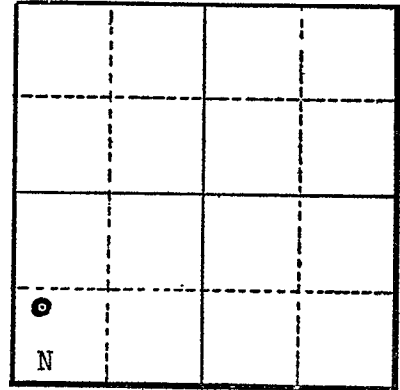

Altitude at well 220'

TYPE OF WELL: Driven Date Constructed Apr. 1947

Depth drilled 21' Depth cased 21'

Section 13

CASING RECORD:
4 inch

FINISH:

Perforated from 15 to 21 feet

AQUIFERS:

Gravel

WATER LEVEL:

10 feet

PUMPING EQUIPMENT: Type Cornell Rainflo, centrifugal 3"x2 $\frac{1}{2}$ " H.P. 15
Capacity 320 G.P.M.

WELL TESTS:

Drawdown ft. after hours G.P.M.
Drawdown ft. after hours G.P.M.

USE OF WATER Irrigation Temp. °F., 19.....

SOURCE OF INFORMATION GR- 837

DRILLER or DIGGER _____

ADDITIONAL DATA:

Log X Water Level Measurements Chemical Analysis Aquifer Test

REMARKS:

All gravel 0 to 21