

STATE ENGINEER  
Salem, Oregon

MARI...  
16283

# Well Record

STATE WELL NO. 10/3W-13N(2)  
COUNTY Marion  
APPLICATION NO. GR-1220

GR- 1180

OWNER: Walter Glasgow

MAILING ADDRESS:


LOCATION OF WELL: Owner's No. #3

CITY AND STATE: Jefferson, Oregon

SW 1/4 SW 1/4 Sec. 13 T. 10 S., R. 3 W., W.M.

Bearing and distance from section or subdivision

corner 4000' S. & 850' E. from NW cor. Sec. 13.

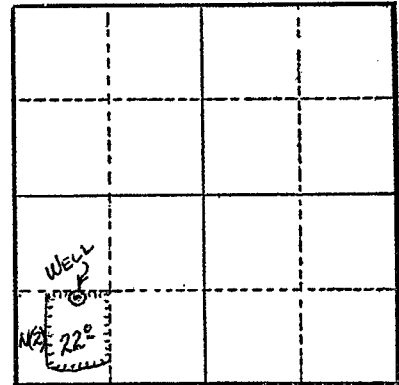

Section 13

Altitude at well 220 ft.

TYPE OF WELL: Drilled Date Constructed 1945

Depth drilled 28 ft. Depth cased 28 ft.

### CASING RECORD:

8 inch

### FINISH:

Perforated from 16 to 28 ft.

### AQUIFERS:

WATER LEVEL: 0.01 (6-24-58) Ppg -  
12 ft.

PUMPING EQUIPMENT: Type F. M. 2 1/2 x 3 in. H.P. 10  
Capacity 350 G.P.M.

### WELL TESTS:

Drawdown ft. after hours G.P.M.  
Drawdown ft. after hours G.P.M.

USE OF WATER Irrigation Temp. °F., 19.

SOURCE OF INFORMATION G. R. Record

DRILLER or DIGGER Orville West

### ADDITIONAL DATA:

Log N.A. Water Level Measurements  Chemical Analysis  Aquifer Test

### REMARKS:

Irrigation of 22 acres.