

STATE ENGINEER
Salem, Oregon

MARION

Well Record

STATE WELL NO. 10/3W - 14A
COUNTY MARION
APPLICATION NO. GR-2193

OWNER: W. F. Weddle


MAILING ADDRESS: Jefferson,

LOCATION OF WELL: Owner's No. #2

CITY AND STATE: Oregon

NE 1/4 NE 1/4 Sec. 14 T. 10 N. S. R. 3 E. W., W.M.

Bearing and distance from section or subdivision corner 929' S. and 610' W.

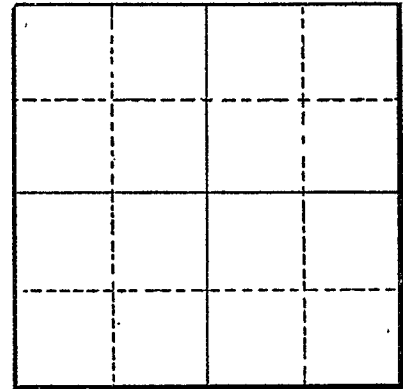

Section

Altitude at well

TYPE OF WELL: Drilled Date Constructed 1948

Depth drilled 20 Depth cased 20

CASING RECORD:

8-Inch

FINISH:

AQUIFERS:

WATER LEVEL:

9' 9"

PUMPING EQUIPMENT: Type Fairbanks Morse H.P. 15
Capacity 400 G.P.M.

WELL TESTS:

Drawdown 11 ft. after Pumping 340 G.P.M.
Drawdown ft. after hours G.P.M.

USE OF WATER Irrigation Temp. °F. 19
SOURCE OF INFORMATION GR-2098

DRILLER or DIGGER

ADDITIONAL DATA:

Log Water Level Measurements Chemical Analysis Aquifer Test

REMARKS: