

STATE ENGINEER
Salem, Oregon

MARION
Leslie

Well Record

STATE WELL NO. 10/3W-14A
COUNTY Marion
APPLICATION NO. GR-1260

GR- 1216

OWNER: W. A. & Goldie M. Stephenson


MAILING ADDRESS:

LOCATION OF WELL: Owner's No.

CITY AND STATE: Jefferson, Oregon

NE 1/4 NE 1/4 Sec. 14 T. 10 S, R. 3 W., W.M.

Bearing and distance from section or subdivision
corner 340' S. & 480' W. from NE cor. Sec. 14.

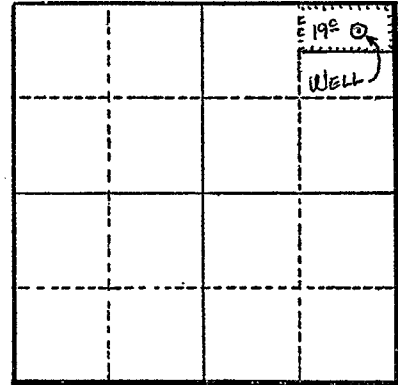

Section 14

Altitude at well 205 ft.

TYPE OF WELL: Drilled Date Constructed 1940

Depth drilled 26 ft. Depth cased 26 ft.

CASING RECORD:

8 inch

FINISH:

AQUIFERS:

WATER LEVEL:

14 ft.

PUMPING EQUIPMENT: Type Pacific 2 in. Cent. H.P. 10

Capacity 200 G.P.M.

WELL TESTS:

Drawdown ft. after hours G.P.M.

Drawdown ft. after hours G.P.M.

USE OF WATER Irrigation Temp. °F. 19

SOURCE OF INFORMATION G. R. Record

DRILLER or DIGGER

ADDITIONAL DATA:

Log N.A. Water Level Measurements Chemical Analysis Aquifer Test

REMARKS:

Irrigation of 19 acres.