

STATE ENGINEER, *171*  
Salem, Oregon

# Well Record

STATE WELL NO. 10/3W-14H(2)  
COUNTY Marion  
APPLICATION NO. GR- 207

*Wells*

OWNER: Leland W. Wells

MAILING ADDRESS:

LOCATION OF WELL: Owner's No. \_\_\_\_\_


CITY AND STATE:

Jefferson, Oregon

SE 1/4 NE 1/4 Sec. 14 T. 10 S., R. 3 W., W.M.

Bearing and distance from section or subdivision

corner 1900' S. & 960' W. from NE cor. of sec. 14

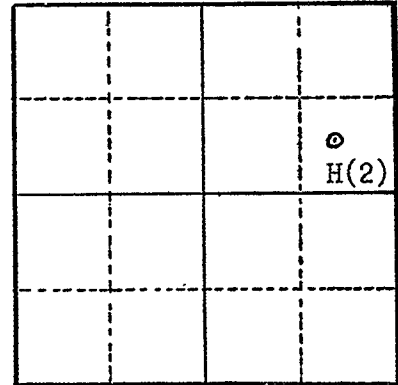

Altitude at well 220'

TYPE OF WELL: Drilled Date Constructed 7/17/55

Depth drilled 30' Depth cased 30'

Section 14

CASING RECORD:  
8 inch

FINISH:

AQUIFERS:

WATER LEVEL:  
14 feet

PUMPING EQUIPMENT: Type Centrifugal H.P. 10  
Capacity 300 G.P.M.

WELL TESTS:  
Drawdown \_\_\_\_\_ ft. after \_\_\_\_\_ hours \_\_\_\_\_ G.P.M.  
Drawdown \_\_\_\_\_ ft. after \_\_\_\_\_ hours \_\_\_\_\_ G.P.M.

USE OF WATER Irrigation (45 acres) Temp. \_\_\_\_\_ °F. \_\_\_\_\_, 19\_\_\_\_

SOURCE OF INFORMATION GR- 192

DRILLER or DIGGER Marion West

ADDITIONAL DATA:  
Log NA Water Level Measurements \_\_\_\_\_ Chemical Analysis \_\_\_\_\_ Aquifer Test \_\_\_\_\_

REMARKS: