

STATE ENGINEER  
Salem, Oregon

16292  
MARI.....

# Well Record

STATE WELL NO. 10/3W-14R  
COUNTY Marion  
APPLICATION NO. GR-1818

GR- 1759

OWNER: Neil L. Stephenson

MAILING  
ADDRESS:

LOCATION OF WELL: Owner's No.


CITY AND  
STATE:

Jefferson, Oregon

SE 1/4 SE 1/4 Sec. 14 T. 10 S., R. 3 W., W.M.

Bearing and distance from section or subdivision

corner 1150' N. & 850' W. from SE cor. Sec. 14

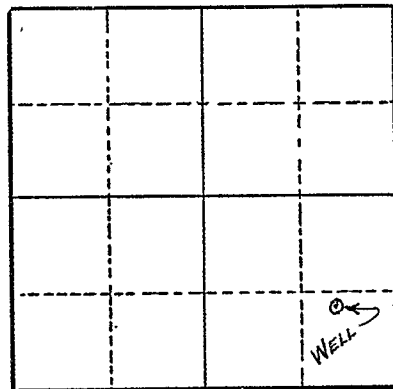

Section 14

Altitude at well

TYPE OF WELL: Driven Date Constructed 1954

Depth drilled 21' Depth cased 21'

### CASING RECORD:

4"

### FINISH:

Perforated

### AQUIFERS:

### WATER LEVEL:

3'

PUMPING EQUIPMENT: Type Pacific Cent. H.P. 10

Capacity 210 G.P.M.

### WELL TESTS:

Drawdown ft. after hours G.P.M.

Drawdown ft. after hours G.P.M.

USE OF WATER Irrigation Temp. °F. 19

SOURCE OF INFORMATION GR Record

DRILLER or DIGGER Bland Sheffield

### ADDITIONAL DATA:

Log Water Level Measurements Chemical Analysis Aquifer Test

### REMARKS:

Log; Soil 0 to 2 ft.  
Gravel 2 to 21 ft.

Irrigation of 30 acres.