

STATE ENGINEER  
Salem, Oregon

MARI.....  
Well Record

STATE WELL NO. 10/6E-17E  
COUNTY ~~Linn~~ Marion  
APPLICATION NO. GR-3481

OWNER: Simpson Redwood Co. dba Simpson Logging Co.


MAILING ADDRESS: 2301 N. Columbia Blvd.

LOCATION OF WELL: Owner's No. ....

CITY AND STATE: Portland, Oregon

SW 1/4 NW 1/4 Sec. 17 T. 10 N. S. R. 6 E. W.M.

Bearing and distance from section or subdivision corner 1522' S. and 953' E.

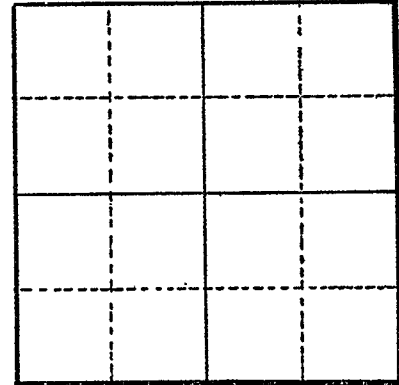

Section 17

Altitude at well .....

TYPE OF WELL: drilled Date Constructed 1954

Depth drilled 106' Depth cased 103'

CASING RECORD:

8"

FINISH:

AQUIFERS:

boulder gravel and sand

WATER LEVEL:

14'

PUMPING EQUIPMENT: Type "Pacific" Turbine H.P. 2  
Capacity 50 G.P.M.

WELL TESTS:

Drawdown ..... ft. after ..... hours ..... G.P.M.  
Drawdown ..... ft. after ..... hours ..... G.P.M.

USE OF WATER domestic, industrial Temp. °F. ...., 19

SOURCE OF INFORMATION GR-3215

DRILLER or DIGGER .....

ADDITIONAL DATA:

Log  Water Level Measurements ..... Chemical Analysis ..... Aquifer Test .....

REMARKS:

boulder gravel and sand 24 24  
muddy sand 38 62  
boulders and sand 30 92  
gravel water bearing 14 106