

STATE ENGINEER
Salem, Oregon

1633
MARION

Well Record

STATE WELL NO. 5/1W-7D(1)
COUNTY Marion
APPLICATION NO. GR-861

OWNER: Ray J. & Elisabeth J. Glatt MAILING ADDRESS: Route 1

LOCATION OF WELL: Owner's No. CITY AND STATE: Woodburn, Oregon

NW 1/4 NW 1/4 Sec. 7 T. 5 N. S., R. 1 W., W.M.

Bearing and distance from section or subdivision corner S. 89° 28' E. 1340' 6" thence S.


11° 24' W. 402' from corner of Sec's.

6 & 7 and 1 & 12 T. 5 S., R. 2 W., W.M.

Altitude at well 182

TYPE OF WELL: Drilled Date Constructed Oct. 1950

Depth drilled 120 Depth cased 120

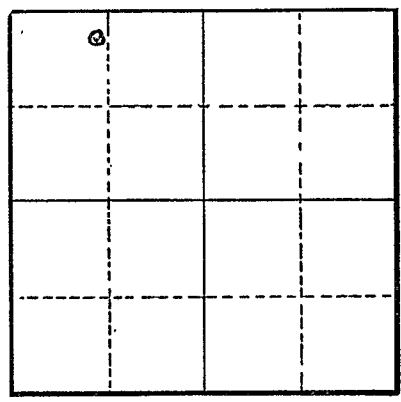

Section 7

CASING RECORD:

10" ID. Galvanized
0 to 120 feet

FINISH:

Welded half coupling for shoe
Gravel packed Perforated acet. torch 3/8" x 6" 100 to 120 feet
Surged to 120 feet

AQUIFERS:

Black sand 100 to 118 feet
Sand and coarse black gravel (118 to 120 feet)

WATER LEVEL:

25 feet 17.20 (1-27-60)

PUMPING EQUIPMENT: Type Peerless Line shaft turbine H.P. 40 Elec.
Capacity 600 G.P.M. vertical hollow shaft

WELL TESTS:

Drawdown 50 ft. after 700 hours G.P.M.
Drawdown ft. after hours G.P.M.

USE OF WATER Irrigation 19.1 acres Temp. °F., 19

SOURCE OF INFORMATION Owner

DRILLER or DIGGER Roy Perkins

ADDITIONAL DATA:

Log Water Level Measurements Chemical Analysis Aquifer Test

REMARKS:

This well was bored with 18" auger to 100' then casing was run. (Welded joints). Well was then gravel packed and surged down to 120 feet.

