

STATE ENGINEER
Salem, Oregon

MAR 31

Well Record

16349

STATE WELL NO. 7/2W-30K(1)
COUNTY Marion
APPLICATION NO. GR-409

OWNER: Irvin S. Pankratz


MAILING ADDRESS: _____

LOCATION OF WELL: Owner's No. _____

CITY AND STATE: Salem, Oregon

NW 1/4 SE 1/4 Sec. 30 T. 7 S., R. 2 W., W.M.

Bearing and distance from section or subdivision corner 1525 feet North and 2900 feet East from SW corner, Section 30

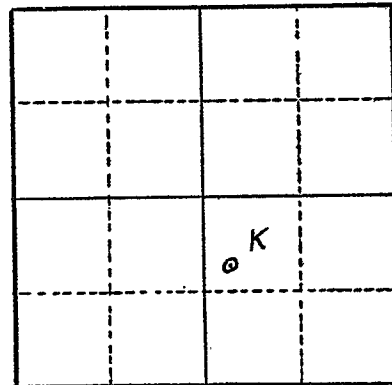

Section 30

Altitude at well 214 feet

TYPE OF WELL: Drilled Date Constructed 1945

Depth drilled 46 Depth cased 46

CASING RECORD:

6-inch

FINISH:

AQUIFERS:

WATER LEVEL:

20 feet

PUMPING EQUIPMENT: Type Fairbanks Morse-Piston H.P. 3/4
Capacity 25 G.P.M.

WELL TESTS:

Drawdown _____ ft. after _____ hours G.P.M.
Drawdown _____ ft. after _____ hours G.P.M.

USE OF WATER Irrigation 1 Temp. _____ °F., 19

SOURCE OF INFORMATION GR-392

DRILLER or DIGGER _____

ADDITIONAL DATA:

Log no Water Level Measurements _____ Chemical Analysis _____ Aquifer Test _____

REMARKS: