
ORIGINAL
File Original and
Duplicate with the
STATE ENGINEER,

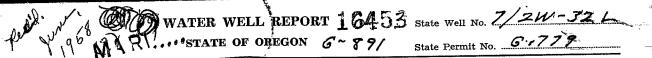

ALEM, OREGON			
1) OWNER:	(11) WELL TESTS: Drawdown is amount we lowered below static level	el	5 . <u>**</u>
Tame WILLIAM 3CHAFER	Was a pump test made? Yes No If yes, by whom:		The second second
ddress 4905 MACLERY	Yield: gal./min. with ft. drawdown	after	hrs.
SALEM DRE	" " "		
2) LOCATION OF WELL:	3 /4	after 2	hrs.
ounty MRXIOII Owner's number, if any—	Bailer test gal./min. with ft. drawdown Artesian flow g.p.m. Date		
1/ 1/ Section T. R. W.M.	Temperature of water 56 Was a chemical analysis made	de? □ Yes	No
earing and distance from section or subdivision corner	Temperature of water 9 was a state of the st		
	(12) WELL LOG: Diameter of well	2 1 4	inches.
Will fix opplication for 1441gotian	Depth drilled 4/1 ft. Depth of completed we		ft.
	Formation: Describe by color, character, size of material show thickness of aquifers and the kind and nature of t stratum penetrated, with at least one entry for each ch	. and struct he materia	ture, and I in each
	stratum penetrated, with at least one entry for each ch	ange of fo	rmation.
	MATERIAL	FROM	TO
TYPE OF WORK (check):	TOPSOIL	3	3
ew Well Deepening Reconditioning Abandon	YPLLOW CLIFY	20'	33.
f abandonment, describe material and procedure in Item 11.	BLUE CLAY	12	30
	PENIENTED GRAVEL	10	37
PROPOSED USE (check): (5) TYPE OF WELL:	WATER GRAVEL 20 G.M.	15'	4/1
omestic Mindustrial Municipal Cable Mindustrial Cable	CEMENTED BRAVEL	1.	4/7
lgation □ Test Well □ Other □ Dug □ Bored □	WATER GRAVEL # 2"-		
ALCONO TAXONATA IND.	RED GRAVEL		
6) CASING INSTALLED: Threaded Welded W			 ·
b" Diam. fromft. toft. Gage	,		
		. 1	
" Diam. from ft. to ft. Gage	14 44		
(7) PERFORATIONS: Perforated? Yes No			
Type of perforator used			
SIZE of perforations in. by in.	Catha Carrier Carrier		ļ
perforations from ft. to ft.		<u> </u>	
perforations fromft. toft.		<u> </u>	
perforations fromft. toft.			<u> </u>
perforations fromft. toft.		-	-
perforations from ft. to ft.	332	 	
(8) SCREENS: Well screen installed ☐ Yes XNo			
ufacturer's Name			
TypeModel No.			
m. Slot size Set from ft. to ft.	TYT 10.7 Completed	9-1	7 1957
Slot size Set from ft. to ft	WORK Statted		*
CONSTRUCTION:	(13) PUMP: Ω)	
was well gravel packed? ☐ Yes 🖈 No Size of gravel:	Manufacturer's Name Berkeley	ung	p.C.
Gravel placed fromft. toft.	Type:	н.р.	<u> </u>
was a surface seal provided? Yes \(\text{No To what depth?} \)			
Material used in seal—	Well Driller's Statement:	and this	report is
Did any strata contain unusable water? Yes No	This well was drilled under my jurisdiction true to the best of my knowledge and belief.	and mis	report 12
Type of water? Depth of strata	S. A. SNEED + SONS		
Method of sealing strata off BACK 7.12.2	NAME (Person, firm, or corporation)	Type or pri	int)
(10) WATER LEVELS:	Address 2505 Brooks ST	_ 504	1. 644, 01
Static level 23 ft. below land surface Date 9-17-5	<u></u>	-	
rtesian pressure lbs. per square inch Date	Driller's well number		
A accorded by	[Cignod]		·
Accepted by:	[Signed] (Well Driller)	Ø . 4	
ed 1 2 School Date 9-17-, 195	License No Date	T - 1]	ر بر المراجب ا
(Owner)			