

STATE ENGINEER
Salem, Oregon

MAR 16 1958

Well Record

STATE WELL NO. 7/2W-32N(1)
COUNTY Marion
APPLICATION NO. GR-216

OWNER: Jerimina Cherry


MAILING ADDRESS: 4658 Macley Road

LOCATION OF WELL: Owner's No. # 1

CITY AND STATE: Salem, Oregon

SW 1/4 SW 1/4 Sec. 32 T. 7 S., R. 2 W., W.M.

Bearing and distance from section or subdivision corner 900 feet East and 600 feet North from SW corner, Section 32

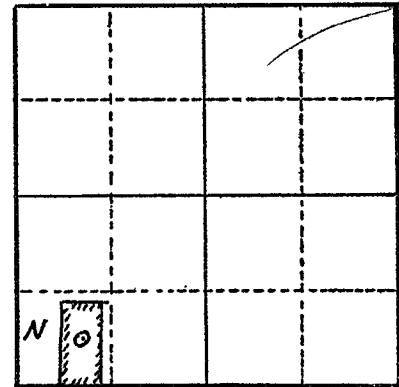

Section 32

Altitude at well 217 feet interpolated

TYPE OF WELL: Dug Date Constructed Aug. 1, 1950

Depth drilled 22 Depth cased 22

CASING RECORD:

12--inch tile set from 0 to 1 foot
33--inch tile set from 1 to 22 feet

FINISH:

none

AQUIFERS:

sand and gravel from 19 to 22 feet

WATER LEVEL:

10 feet below land surface fall of year

PUMPING EQUIPMENT: Type Meyers centrifugal H.P. 4
Capacity 40 G.P.M.

WELL TESTS:

Drawdown 20 ft. after hours pumping 40 G.P.M.
Drawdown ft. after hours G.P.M.

USE OF WATER Irrigation 15 Temp. °F., 19

SOURCE OF INFORMATION GR-201

DRILLER or DIGGER

ADDITIONAL DATA:

Log Water Level Measurements Chemical Analysis Aquifer Test

REMARKS:

Clay, heavy, blue 0 19
Sand and gravel 19 22