

STATE ENGINEER
Salem, Oregon


~~16524~~ 16524
Well Record
MIRI..... GR- 1062

STATE WELL NO. ^{2W} 7/21-33R
COUNTY Marion
APPLICATION NO. GR- 1101

OWNER: Roderick M. Livesley
MAILING ADDRESS: _____

LOCATION OF WELL: Owner's No. _____
CITY AND STATE: Salem, Oregon

SE 1/4 SE 1/4 Sec. 33 T. 7 S. R. 3 W., W.M.
Bearing and distance from section or subdivision
corner 1200' W. & 1000' N. from SE cor. Sec. 33.

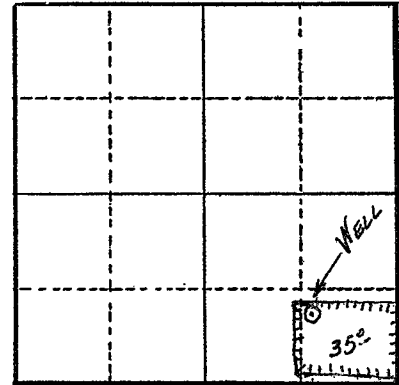

Altitude at well 285 ft.

TYPE OF WELL: Drilled Date Constructed 1950

Depth drilled 130 ft. Depth cased 130 ft.

Section 33

CASING RECORD:
10 inch

FINISH:

AQUIFERS:

WATER LEVEL:
32 ft.

PUMPING EQUIPMENT: Type _____ H.P. _____
Capacity _____ G.P.M.

WELL TESTS:
Drawdown 75 ft. after _____ hours 85 G.P.M.
Drawdown _____ ft. after _____ hours _____ G.P.M.

USE OF WATER Irrigation Temp. _____ °F. _____, 19_____

SOURCE OF INFORMATION G. R. Record

DRILLER or DIGGER Studebaker Bros.

ADDITIONAL DATA:
Log N.A. Water Level Measurements _____ Chemical Analysis _____ Aquifer Test _____

REMARKS:

Irrigation of 35 acres.