

STATE ENGINEER
Salem, Oregon

~~MA 710000~~
16525

Well Record

STATE WELL NO. 7/2W-33B(1)
COUNTY Marion
APPLICATION NO. GR-1041

GR- 1004

OWNER: Valma M. Faria

MAILING ADDRESS:


LOCATION OF WELL: Owner's No.

CITY AND STATE:

Salem, Oregon

NW 1/4 NE 1/4 Sec. 33 T. 7 S, R. 2 W., W.M.

Bearing and distance from section or subdivision corner 180° W. & 120° S. from NE cor. Sec. 33.

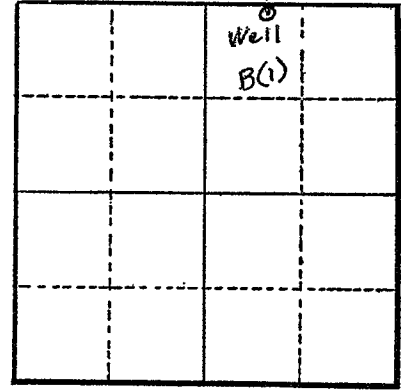

Section 33

Altitude at well 230 ft.

TYPE OF WELL: Drilled Date Constructed 1946

Depth drilled 93 ft. Depth cased 90 ft.

CASING RECORD:

6 inch

FINISH:

AQUIFERS:

WATER LEVEL:

36 ft.

PUMPING EQUIPMENT: Type Berkeley Turbine

H.P. 5

Capacity 125 G.P.M.

WELL TESTS:

Drawdown 62 ft. after 55 hours G.P.M.

Drawdown ft. after hours G.P.M.

USE OF WATER Irrigation Temp. °F. 19

SOURCE OF INFORMATION G.R. Record

DRILLER or DIGGER

ADDITIONAL DATA:

Log N.A. Water Level Measurements Chemical Analysis Aquifer Test

REMARKS:

Irrigation of 12 acres.