

STATE ENGINEER  
Salem, Oregon

# Well Record

STATE WELL NO. 7/3W-14H  
COUNTY Marion  
APPLICATION NO. GR-1554

GR- 1498

OWNER: Cascade Meats, Inc.


MAILING  
ADDRESS:

LOCATION OF WELL: Owner's No. #1

CITY AND  
STATE: Salem, Oregon

SE 1/4 NE 1/4 Sec. 14 T. 7 S., R. 3 W., W.M.

Bearing and distance from section or subdivision  
corner 790' W. & 2330' S. from NE cor. Sec. 14.

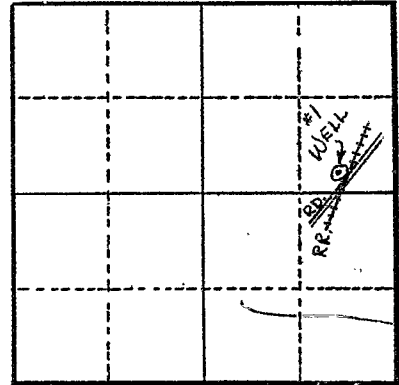

Section 14

Altitude at well 150'

TYPE OF WELL: Drilled Date Constructed 1948

Depth drilled 181' Depth cased 161'

CASING RECORD:  
12"

### FINISH:

Perforated with 8 rows from: 65' to 77' 134' to 138'  
123' to 128' 141' to 151'

### AQUIFERS:

WATER LEVEL:  
29'

PUMPING EQUIPMENT: Type Peerless 6" H.P. 30  
Capacity 250 G.P.M.

### WELL TESTS:

Drawdown 39 ft. after \_\_\_\_\_ hours 250 G.P.M.  
Drawdown 89 ft. after \_\_\_\_\_ hours 500 G.P.M.

USE OF WATER Industrial Temp. \_\_\_\_\_ °F., 19

SOURCE OF INFORMATION GR Record

DRILLER or DIGGER \_\_\_\_\_

### ADDITIONAL DATA:

Log  Water Level Measurements \_\_\_\_\_ Chemical Analysis \_\_\_\_\_ Aquifer Test \_\_\_\_\_

### REMARKS:

