

STATE ENGINEER
Salem, Oregon

1665
MARI.....

Well Record

GR- 1478

STATE WELL NO. 5/1W-8A
COUNTY Marion
APPLICATION NO. GR- 1535

OWNER: J. A. & Juanita Eobert


MAILING ADDRESS: Rt. 1, Box 87

LOCATION OF WELL: Owner's No. #1

CITY AND STATE: Woodburn, Oregon

NE 1/4 NE 1/4 Sec. 8 T. 5 S. R. 1 W., W.M.

Bearing and distance from section or subdivision corner 400' S. & 750' W. from NE cor. Sec. 8

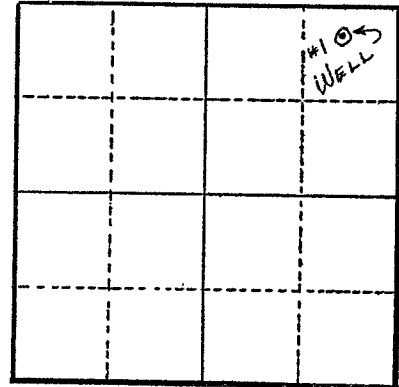

Section 8

Altitude at well 178'

TYPE OF WELL: Drilled Date Constructed 1951

Depth drilled 127' Depth cased 127'

CASING RECORD:

8"

FINISH:

Drive down perforations: 3 rows of 1/4" x 2" (15/ft.) from 118' to 126'

AQUIFERS:

WATER LEVEL:

30'

PUMPING EQUIPMENT: Type Peerless turbine 8" H.P. 10
Capacity 320 G.P.M.

WELL TESTS:

Drawdown 17 ft. after 250 hours G.P.M.

Drawdown ft. after hours G.P.M.

USE OF WATER Irrigation Temp. °F. 19

SOURCE OF INFORMATION GR Record

DRILLER or DIGGER Jim Beier

ADDITIONAL DATA:

Log Water Level Measurements Chemical Analysis Aquifer Test

REMARKS:

- Log: Top soil 0 to 2 ft.
- Yellow clay 2 to 28 ft.
- Yellow sandy clay 28 to 33 ft.
- Blue clay 33 to 65 ft.
- Black sand 65 to 70 ft. (water)
- Blue clay 70 to 117 ft.
- Black sand & gravel 117 to 127 ft. (water)

Irrigation of 40 acres.