

STATE ENGINEER
Salem, Oregon

Well Record

STATE WELL NO. 5/1W-8H(1)
COUNTY Marion
APPLICATION NO. GR-2827

MARI... 1666

OWNER: J. A. Tiedman


MAILING ADDRESS:

LOCATION OF WELL: Owner's No.

CITY AND STATE:

SE 1/4 NE 1/4 Sec. 8 T. 5 S., R. 1 W., W.M.

Bearing and distance from section or subdivision corner

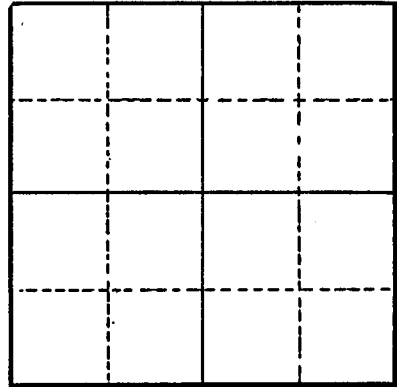

Section 8

Altitude at well

TYPE OF WELL: Date Constructed

Depth drilled Depth cased

CASING RECORD:

FINISH:

AQUIFERS:

WATER LEVEL:

PUMPING EQUIPMENT: Type H.P.
Capacity G.P.M.

WELL TESTS:
Drawdown ft. after hours G.P.M.
Drawdown ft. after hours G.P.M.

USE OF WATER Temp. °F., 19

SOURCE OF INFORMATION Well net & GR-2827

DRILLER or DIGGER

ADDITIONAL DATA:
Log Water Level Measurements Chemical Analysis Aquifer Test

REMARKS:

MARI
1666

State Well No. 5/W-84(1)

County MARION

Application No. GR-2827

Water Level Record

OWNER: J. A. TIEDMAN OWNER'S NO. _____

Description of measuring point: TOP OF CASING 0.7' ABOVE L.S.D. ON E. SIDE

Date	Water Level Feet (above) (below) Land Surface	Remarks	Date	Water Level Feet (above) (below) Land Surface	Remarks
8-3-61	42.50	WSB			

REMARKS: _____

